



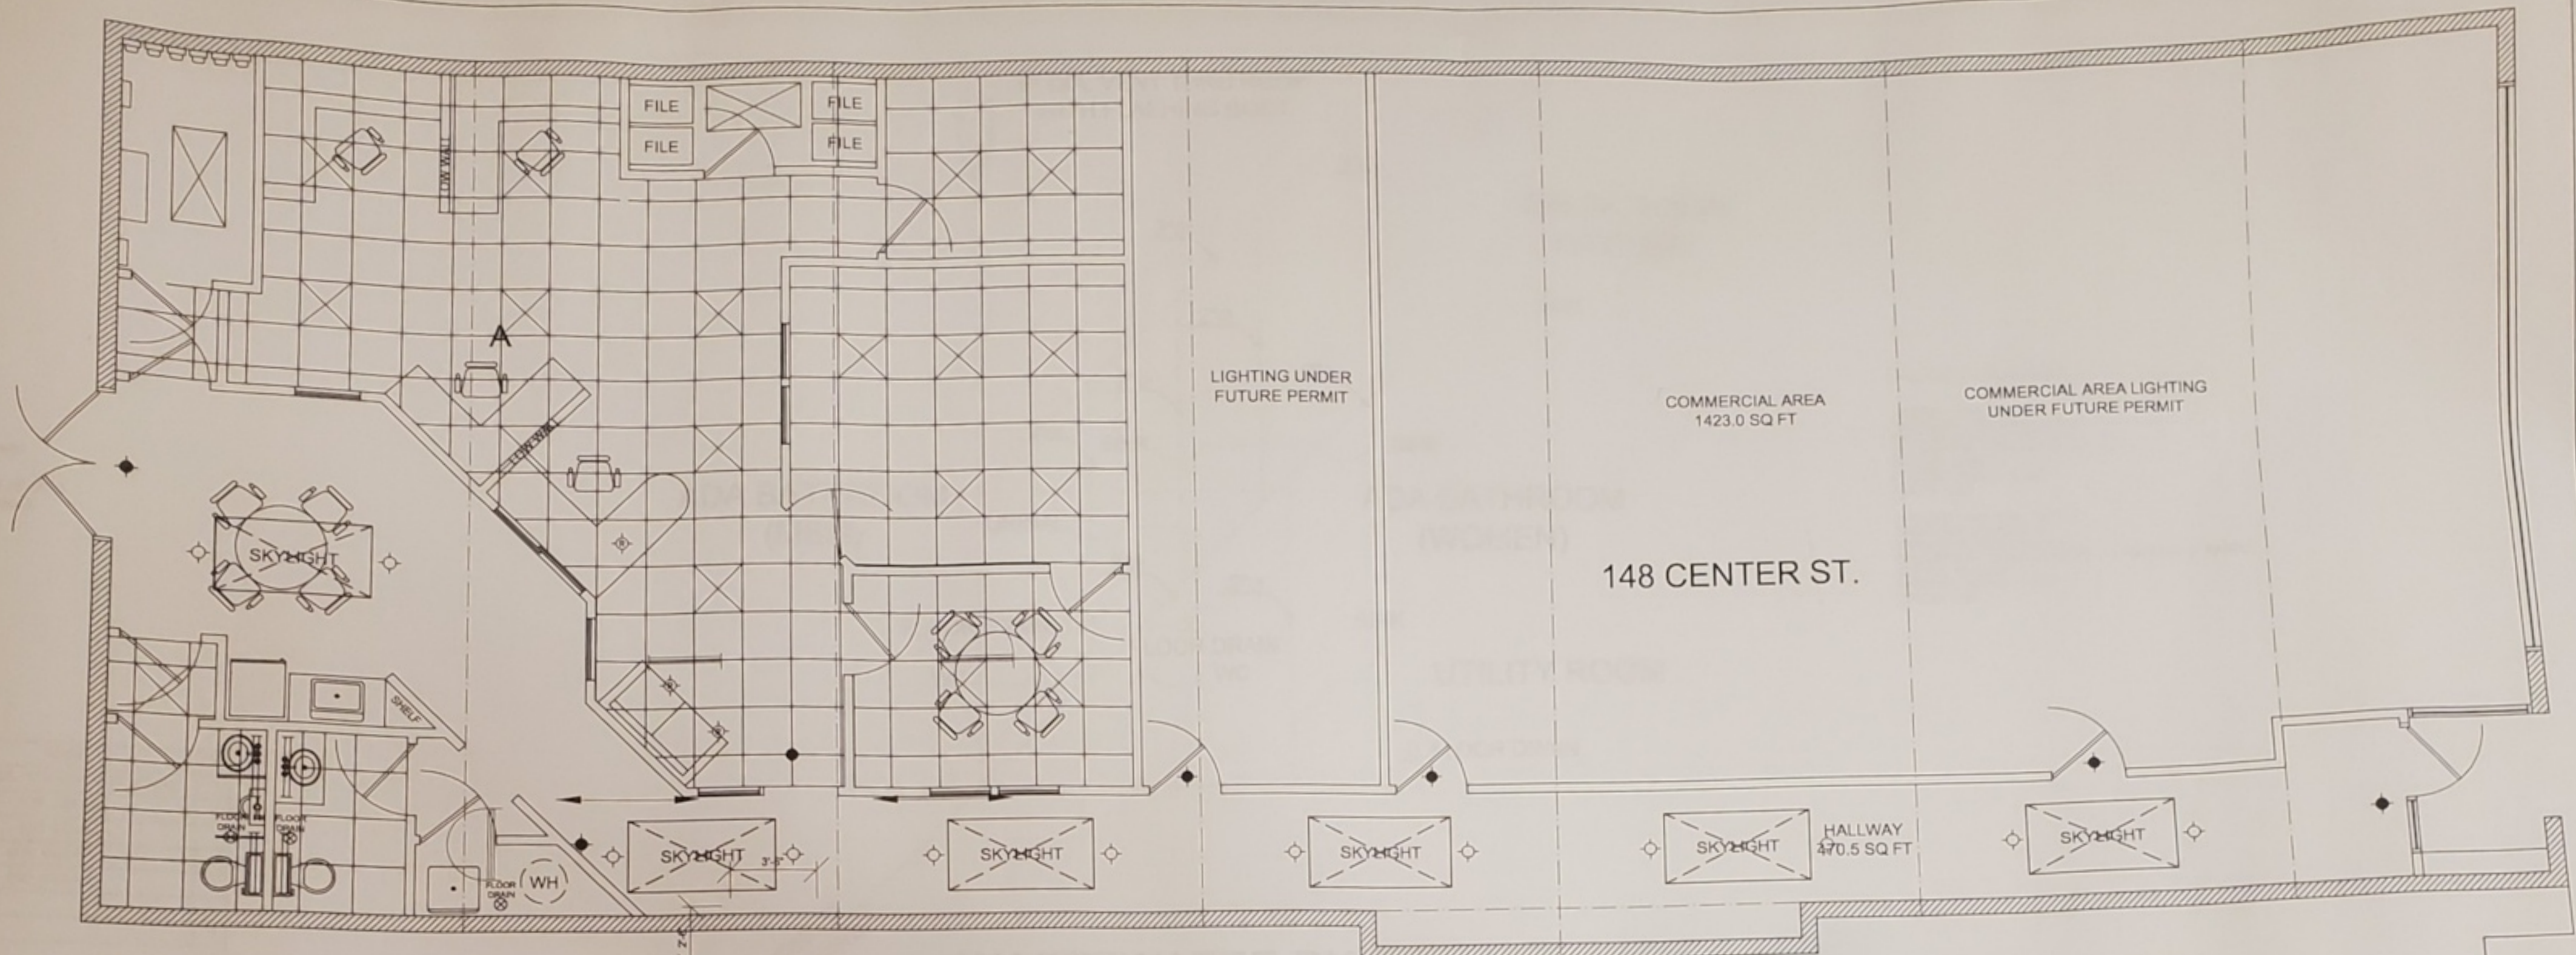

PROPOSED LIGHTING PLAN (148 CENTER STREET)

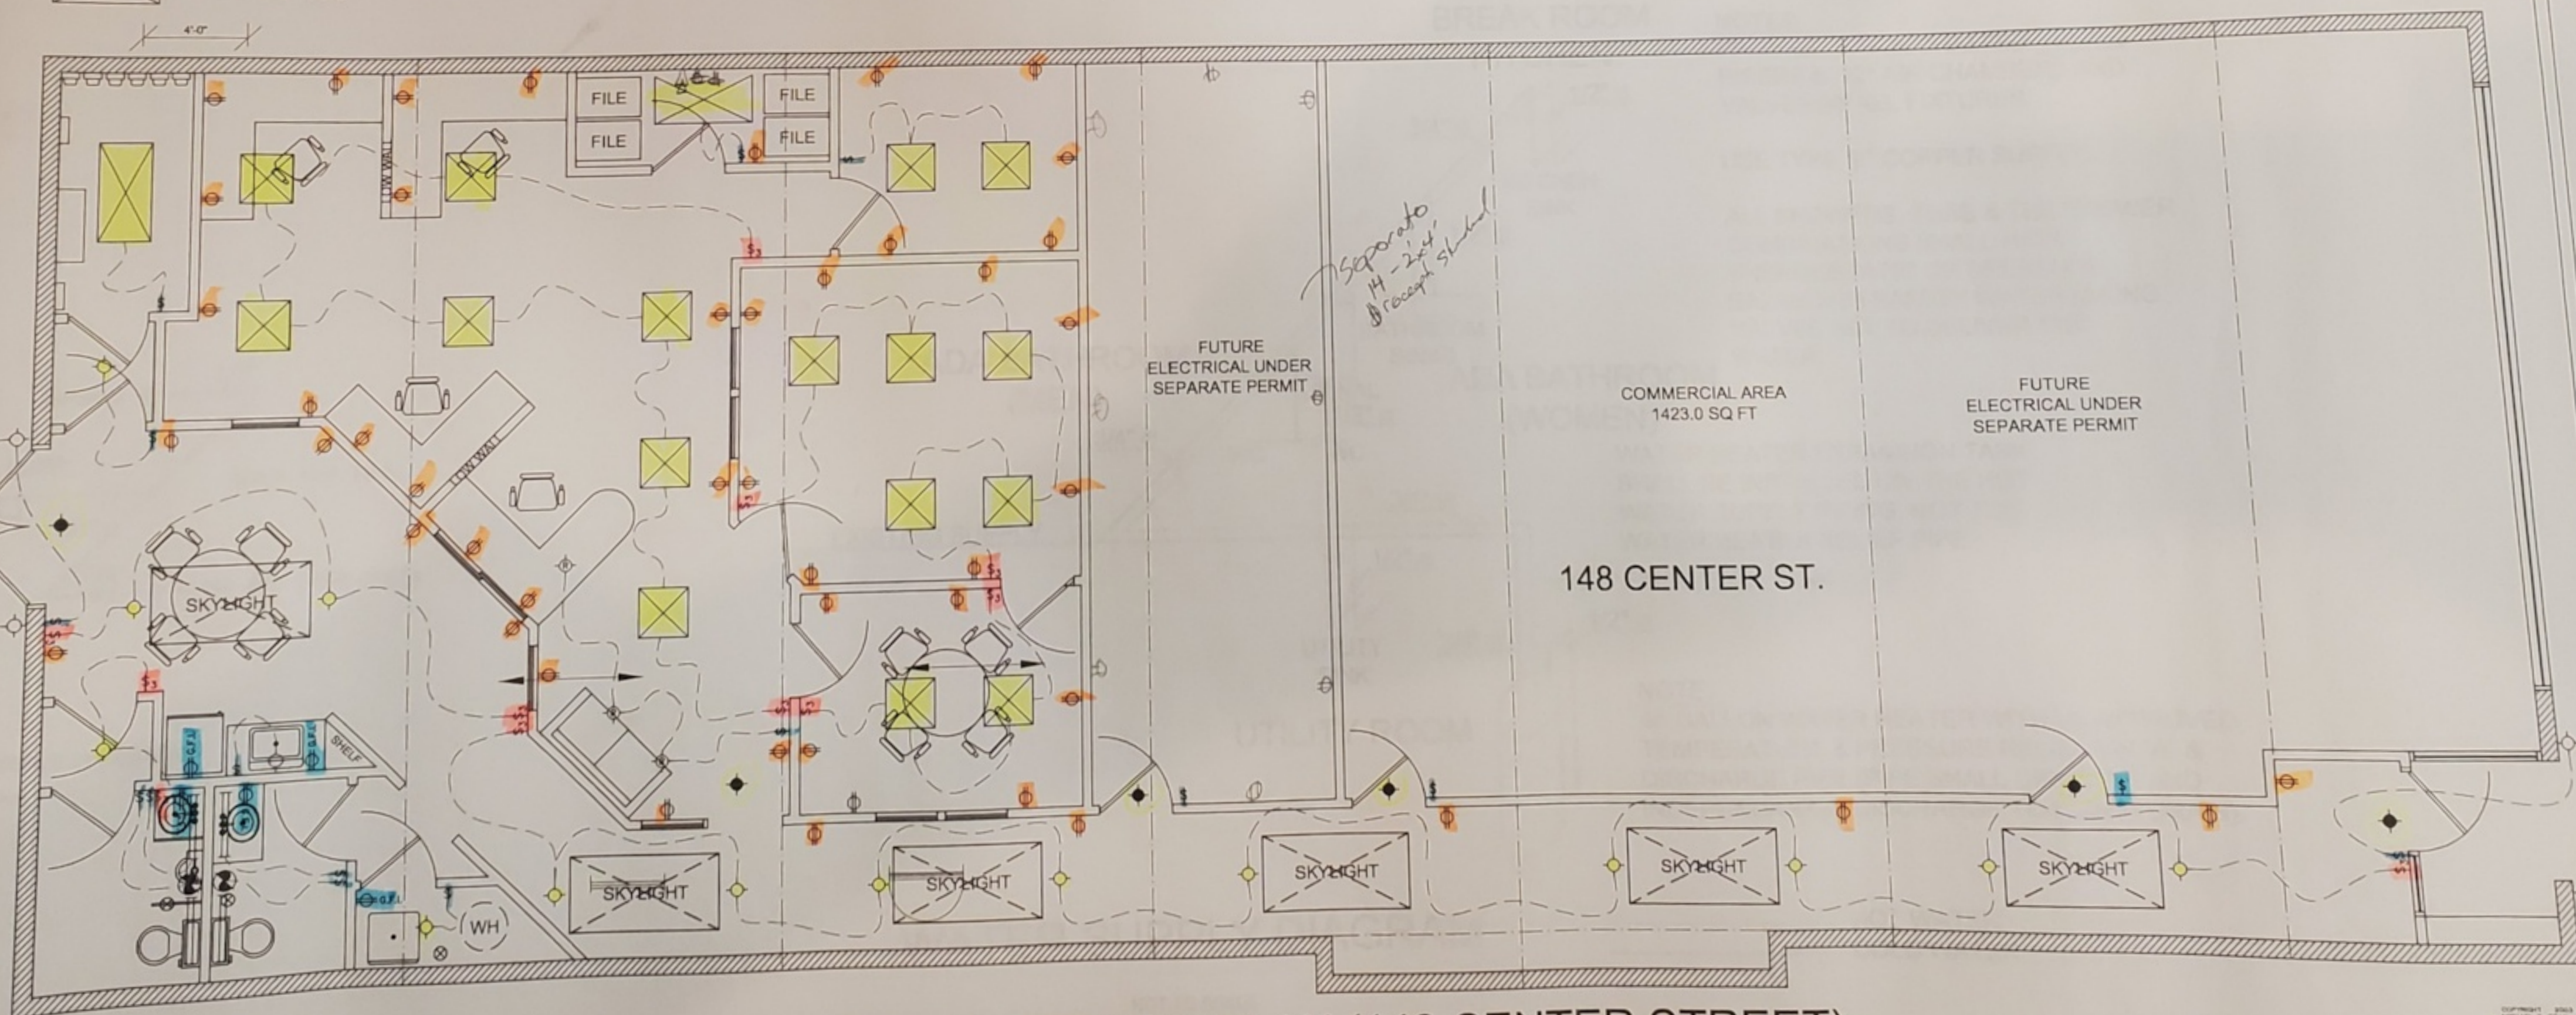

PROPOSED ELECTRICAL PLAN (148 CENTER STREET)

RETAIL STORE RENOVATION

148 CENTER STREET, GRAYSLAKE, ILLINOIS

DEPT. OF BUILDING & ZONING
VILLAGE OF GRAYSLAKE

☐ Approved
☒ Approved as Noted 4/19/2004
☐ Revise & Resubmit
☐ Not Approved
By [Signature]
BLDG. COMMISSIONER 5/20/04

NOTICE:
REVIEW AND/OR APPROVAL OF THESE PLANS IS NOT
MEANT TO IMPLY THAT ALL ERRORS & OMISSIONS
HAVE BEEN NOTED. NOR DOES IT RELIEVE THE
APPLICANT/CONTRACTOR OF THE OBLIGATION TO
COMPLY WITH ALL STATE, COUNTY, AND LOCAL
CODES AND ORDINANCES.

THIS PLAN IS SUBJECT TO
THE REQUIREMENTS OF:
B O C A

THIS PLAN IS SUBJECT TO THE
REQUIREMENTS OF:
NATIONAL ELECTRICAL CODE

THIS PLAN IS SUBJECT TO THE
REQUIREMENTS OF:
THE ONE & TWO FAMILY
DWELLING CODE

THIS PLAN IS SUBJECT TO
THE REQUIREMENTS OF:
THE ILLINOIS
ACCESSIBILITY CODE

BOOK 97 PAGE 1945 ORDER NO. 97-1945 LIBERTYVILLE NOV. 22, 1997

PARCEL 1: LOT 13 (EXCEPT THAT PORTION THEREOF DESCRIBED AS FOLLOWS, TO WIT: COMMENCING AT A POINT ON THE SOUTH LINE OF SAID LOT 13 WHICH IS 27 FEET WEST OF THE SOUTHEAST CORNER OF SAID LOT; THENCE NORTHERLY, 150.35 FEET, MORE OR LESS, TO A POINT IN THE NORTH LINE OF SAID LOT WHICH IS 27.85 FEET WEST OF THE NORTHEAST CORNER OF SAID LOT; THENCE EAST ALONG THE NORTH LINE TO THE NORTHWEST CORNER OF SAID LOT, SOUTH ALONG THE EAST LINE OF SAID LOT TO THE SOUTHEAST CORNER OF SAID LOT AND THENCE WEST ALONG THE SOUTH LINE OF SAID LOT TO THE POINT OF BEGINNING) IN BLOCK 3 IN GRAYSLAKE, BEING A SUBDIVISION IN THE SOUTHWEST 1/4 OF THE SOUTHWEST 1/4 OF SECTION 26, TOWNSHIP 43 NORTH, RANGE 10 EAST OF THE THIRD PRINCIPLE MERIDIAN, ACCORDING TO THE PLAT THEREOF, RECORDED JANUARY 14, 1885 AS DOCUMENT 33104 IN BOOK 82 OF DEEDS, PAGE 420, IN GRAYSLAKE, ILLINOIS.

PARCEL 2: THE EAST 32 FEET OF LOT 12 IN BLOCK 3 ORIGINAL PLOT OF GRAYSLAKE, A SUBDIVISION OF PART OF THE SOUTH 1/2 OF THE SOUTHWEST 1/4 SECTION 26, TOWNSHIP 43 NORTH, RANGE 10, EAST OF THE THIRD PRINCIPLE MERIDIAN, ACCORDING TO THE PLAT THEREOF, RECORDED JANUARY 14, 1885 AS DOCUMENT 33104 IN BOOK 82 OF DEEDS, PAGE 240, IN LAKE COUNTY, ILLINOIS.

COMMONLY KNOWN AS 146-148 CENTER STREET, GRAYSLAKE, ILLINOIS.

WEST FACE OF THE
BUILDING IS 0.18' EAST

EAST FACE OF THE
BUILDING IS 0.07' EAST

WEST FACE OF THE
BUILDING IS 0.23' EAST
AND 5.37' NORTH

EAST FACE OF THE
BUILDING IS 0.20' EAST

13

ASPHALT AREA

12

ASPHALT AREA

JOINT BETWEEN
BUILDINGS IS 0.01' EAST

JOINT BETWEEN
BUILDINGS IS 0.06' EAST
AND 5.36' NORTH

1 STORY
STONE & CONCRETE BLOCK
BUILDING 148

1 STORY
STONE & CONCRETE BLOCK
BUILDING 146

CONC


SITE PLAN

SCALE: 1/8" = 1' - 0"


3/23/04

exp 11/30/04

EXHIBIT A
SITE PLAN

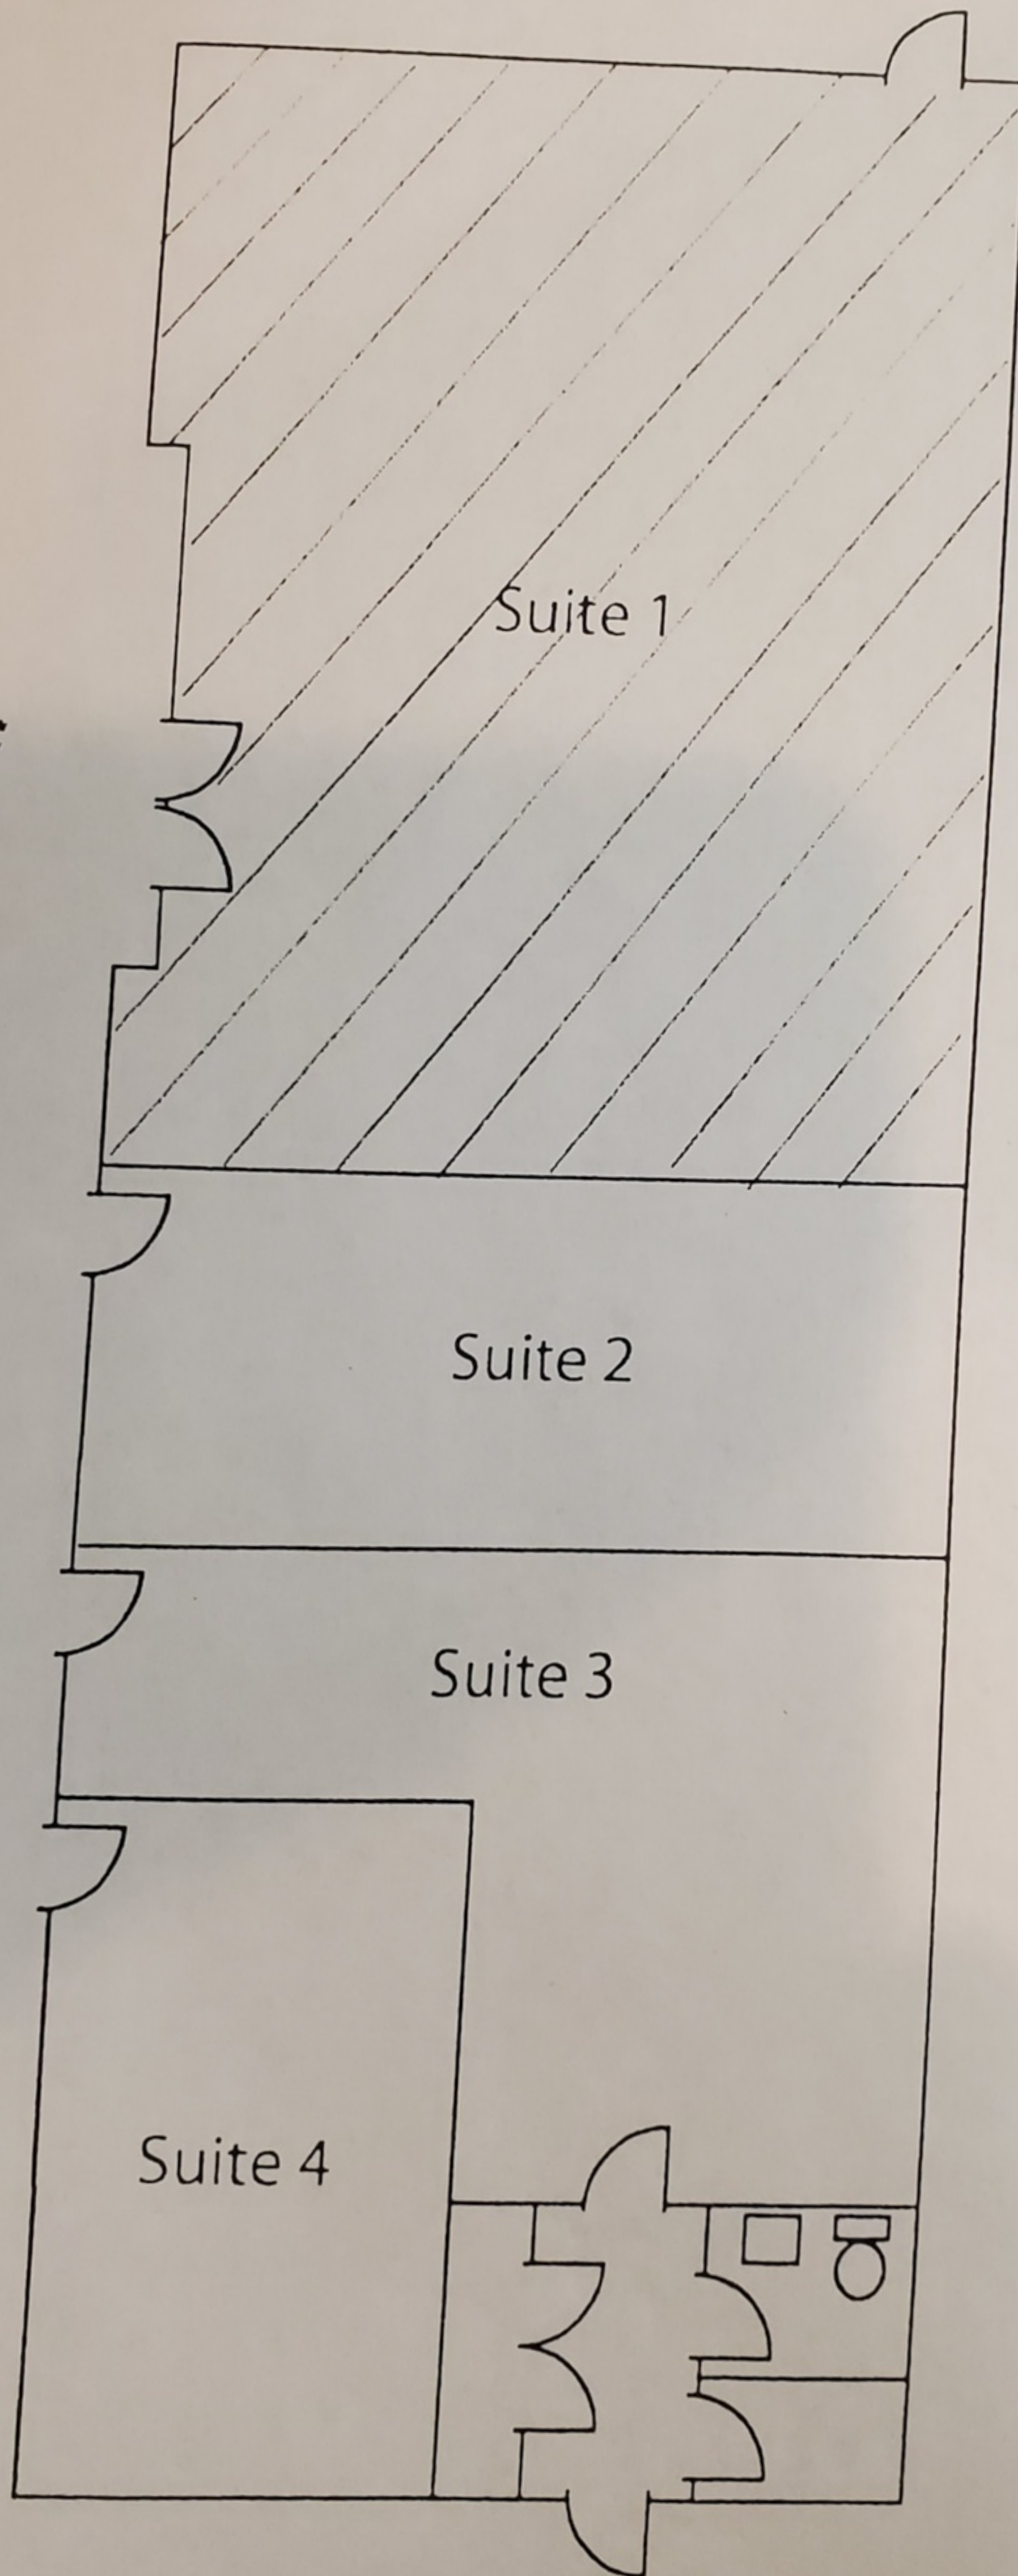

Drawing is not to scale. For site location only.

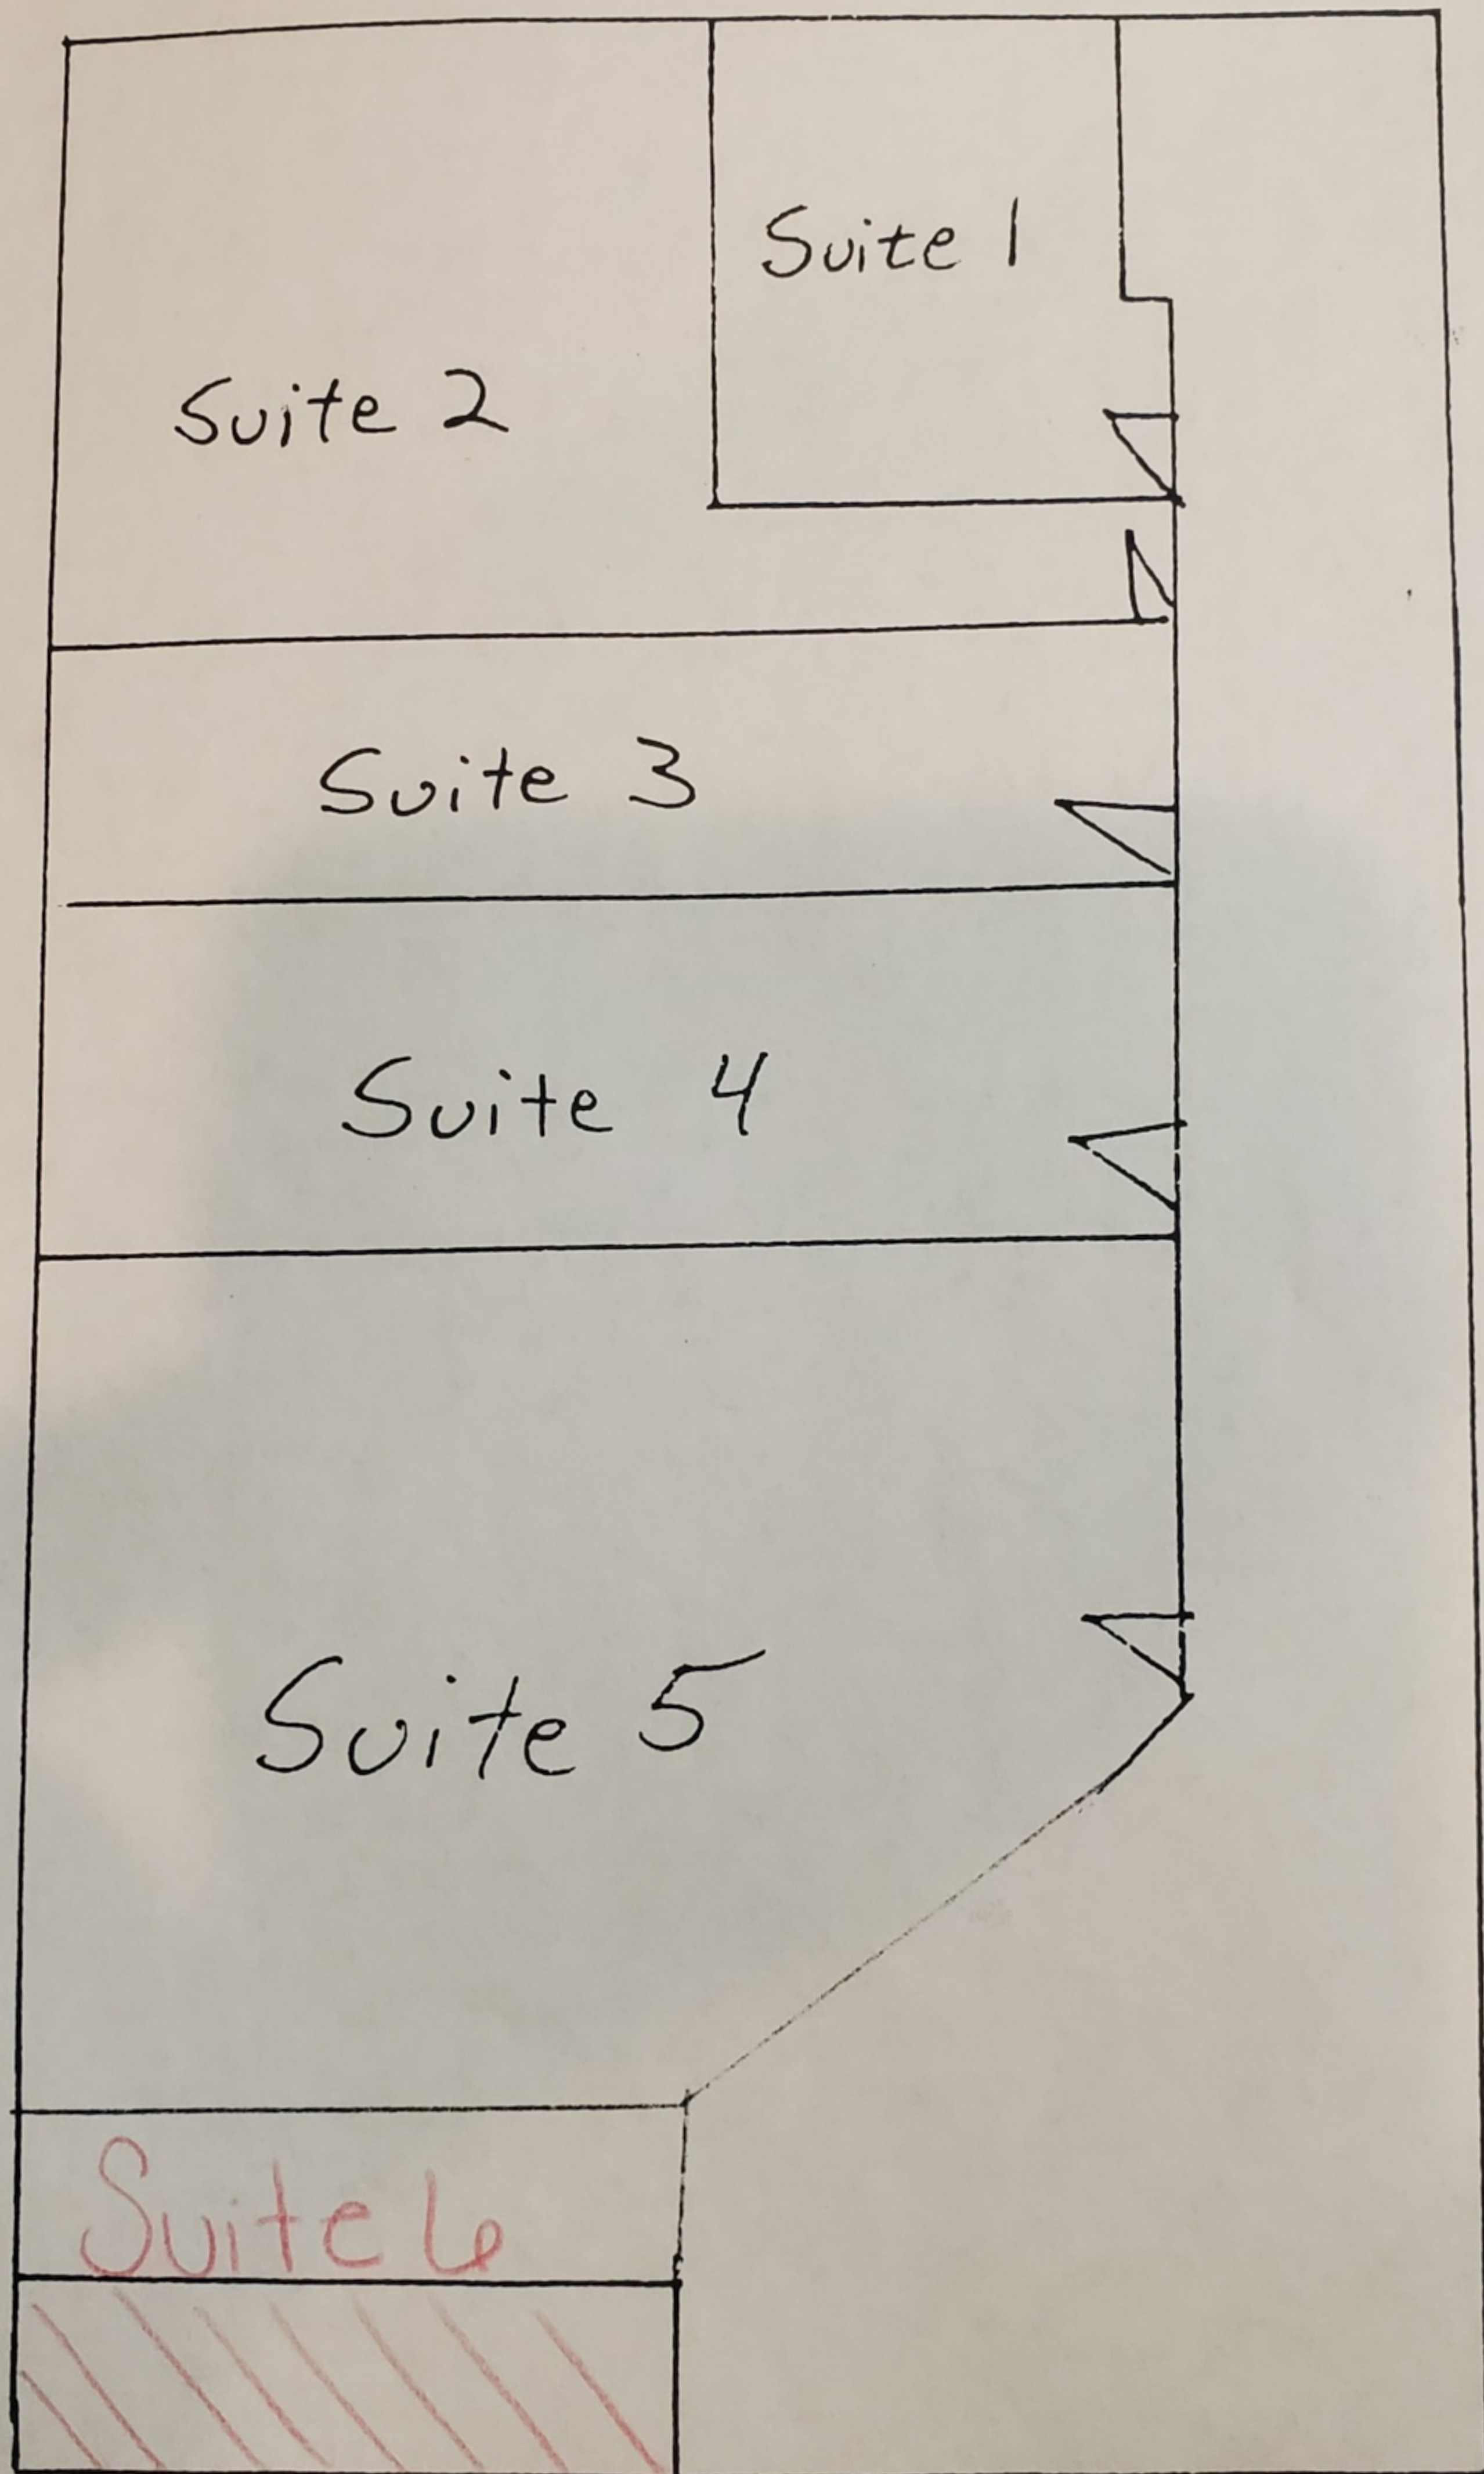

* Drawing is not to scale. 22
It is only for general location of leasable space.